



Civil Engineers
Structural Engineers
Traffic Engineers
Land Surveyors
Landscape Architects
Scientists

LACONIA VILLAGE SEWER/WATER MASTER PLANNING CAPACITY

March 28, 2025 (rev1 May 30, 2025)

SEWER DEMAND

Sewer demand and offsite sewer capacity for the proposed Laconia State School project is summarized below. Flow Calculations (attached) are based on NHDES Table 1008-1.

Current flow.

Dwinnell building (E-911 dispatch center):

50 employees daily X 15 GPD / Employee = 750 GPD plus infiltration from leaking sewer network
This building will be vacated prior to Phase 1 construction and thus can be disregarded in full-build calculations.

Phase 1: Daily Flow:

49,800 GPD Usage + 500 GPD Infiltration = 50,300 GPD

50,300 GPD Average x peaking factor = 6¹; thus Peak Flow = 0.47 cfs

8" Pipe Capacity (see below) = 1.6 cfs > 0.47 cfs = **OKAY**

Full Build: Daily Flow:

49,800 GPD + 577,000 GPD = 627,300 GPD Usage + 10,000 GPD Infiltration = 637,000 GPD

637,000 GPD Average x peaking factor = 4.4¹; thus Peak Flow = 4.3 cfs

12" Pipe Capacity (see below) = 6.6 cfs < 4.3 cfs = **OKAY**

SEWER CAPACITY

Existing Offsite Sewer to Opechee Interceptor

The sewer for the site crosses Parade Road near Old N Main Street, as shown in plan and profile views on the following page. The minimum pipe slope is in the 8" sewer upstream of the crossing from Sewer Shed to SMH#505. This pipe is an 8" PVC sewer at slope S=0.014 ft/ft. The next flattest pipe is S=0.028.

Existing Capacity of 8" sewer from Shed to SMH-505 at S=0.014 ft/ft

- 8" Pipe Capacity at S=0.014 (80% Manning's full flow) = 1.6 cfs

Consider rebuild pipe @10" sewer from Shed to SMH-505 at S=0.028 ft/ft

- 10" Pipe Capacity at S=0.028 (80% Manning's full flow) = 4.1 cfs

Consider rebuild pipe @12" sewer from Shed to 48" Interceptor at S=0.028 ft/ft

- 12" Pipe Capacity at S=0.028 (80% Manning's full flow) = 6.6 cfs

SUMMARY

Phase 1 - Existing offsite sewer capacity to WRBP Opechee Interceptor is sufficient for Phase 1.

Full-Build - Offsite sewer to be replaced with 12" PVC under Parade Road to Opechee Interceptor.


¹ Peaking Factors based on Figure 2.1 of TR-16 "Guides for the Design of Wastewater Treatment Works", New England Interstate Water Pollution Control Commission, 2011 Edition

1.) Flow Calculations (based on Env-Wq 1008.03 Table 1008-1) **See Site Layout**


UNITS	USE	FLOW RATE	FLOW
65,000	S.F. Supermarket with Meat Department with Garbage Grinder (Phase 1)	11 GPD / 100 S.F.=	7,150 GPD
25,000	S.F. Retail (Dry Goods) (Phase 1)	5 GPD / 100 S.F.=	1,250 GPD
45	Employees. Retail (Dry Goods) (Phase 1)	10 GPD / employee=	450 GPD
60	1 Bedrooms Residential Multifamily - Senior Units (Full Build)	225 GPD / BR =	13,500 GPD
38	1 Bedrooms Residential Multifamily Units (Full Build)	225 GPD / BR =	8,550 GPD
28	2 Bedrooms Residential Multifamily Units (Full Build)	150 GPD / BR =	8,400 GPD
14	2 Bedrooms Residential Duplex Units (Phase 1)	150 GPD / BR =	4,200 GPD
14	3 Bedrooms Residential Duplex Units (Phase 1)	150 GPD / BR =	6,300 GPD
		Phase 1 Sub Total	49,800 GPD
30,000	S.F. Retail (Dry Goods) (Phase 2 & 3)	5 GPD / 100 S.F.=	1,500 GPD
55	Employees. Retail (Dry Goods) (Phase 2 & 3)	10 GPD / employee=	550 GPD
60,000	S.F. Office (Medical) (Phase 2)	5 GPD / 100 S.F.=	3,000 GPD
40,000	S.F. Office (Small) (Full Build)	5 GPD / 100 S.F.=	2,000 GPD
500	participants, Recreation (No Showers, i.e. Bowling) (Phase 2)	5 GPD / participant	2,500 GPD
125	BR Hotel Hospitality (Phase 3)	200 GPD / BR =	50,000 GPD
15	Employees Hotel Hospitality (Full Build)	10 GPD / employee=	150 GPD
335	seats, Civic (Civic Club) (Full Build)	10 GPD/Seat =	3,350 GPD
280	2 Bedrooms Residential Townhouse Units (Full Build)	150 GPD / BR =	84,000 GPD
36	2 Bedrooms Residential Duplex Units (Full Build)	150 GPD / BR =	10,800 GPD
36	3 Bedrooms Residential Duplex Units (Full Build)	150 GPD / BR =	16,200 GPD
208	1 Bedrooms Residential Triplex/Quadplex Units (Full Build)	225 GPD / BR =	46,800 GPD
208	2 Bedrooms Residential Triplex/Quadplex Units (Full Build)	150 GPD / BR =	62,400 GPD
83	1 Bedrooms Residential Courtyard/Cottage Court Units (Full Build)	225 GPD / BR =	18,675 GPD
83	2 Bedrooms Residential Courtyard/Cottage Court Units (Full Build)	150 GPD / BR =	24,900 GPD
20	4 Bedrooms Residential Live/Work Units (Phase 3)	150 GPD / BR =	12,000 GPD
190	1 Bedrooms Residential Multifamily - Senior Units (Full Build)	225 GPD / BR =	42,750 GPD
262	1 Bedrooms Residential Multifamily Units (Full Build)	225 GPD / BR =	58,950 GPD
455	2 Bedrooms Residential Multifamily Units (Full Build)	150 GPD / BR =	136,500 GPD
		Future Build Sub Total	577,025 GPD
4"	Sewer Infiltration Allowance 300 / inch pipe diameter / mile or 0.23 per lf	4000 LF	920 GPD
6"	Sewer Infiltration Allowance 300 / inch pipe diameter / mile or 0.34 per lf	2000 LF	680 GPD
8"	Sewer Infiltration Allowance 300 / inch pipe diameter / mile or 0.45 per lf	18666 LF	8,400 GPD
		Infiltration Allowance Sub Total	10,000 GPD
Daily Average Flow =		Total	636,825 GPD

REMOVE WOODEN PUMP HOUSE BUILDING
SALVAGE CONCRETE FOUNDATION
SALVAGE SEWER PUMPS TO PRISON MAINTENANCE
CONST BRICK SEWER INVERTS IN FOUNDATION
CONST CONCRETE SLAB COVER (H-20 LOADING)
CONST SEWER MANHOLE FRAME AND COVER

PLUG AND ABANI
AT BOTH ENDS

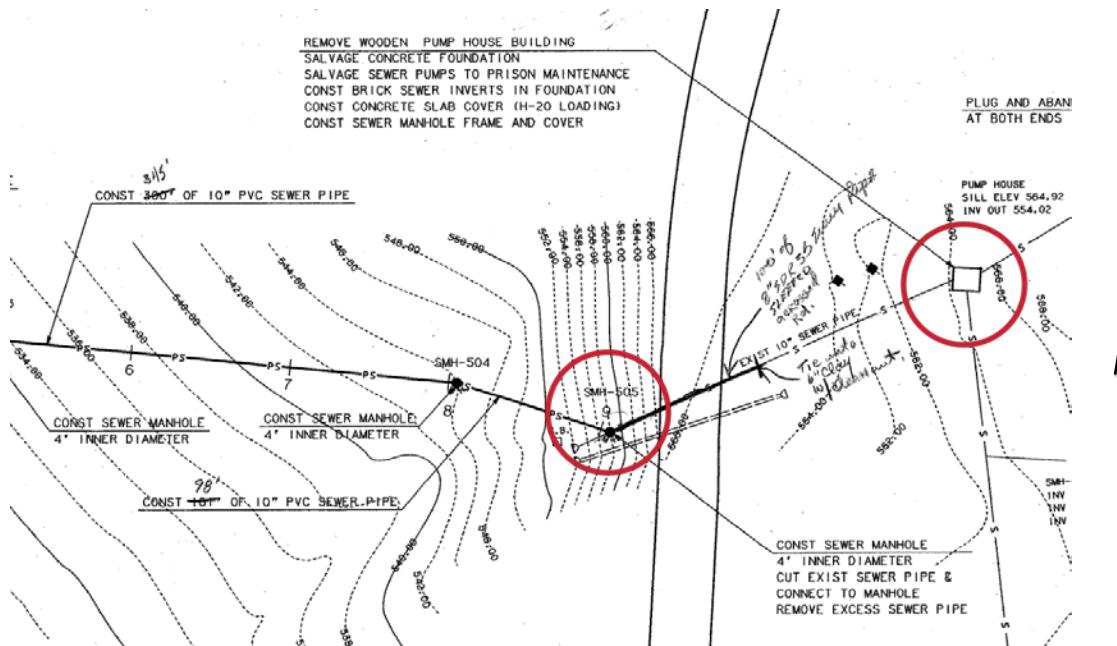

PLAN

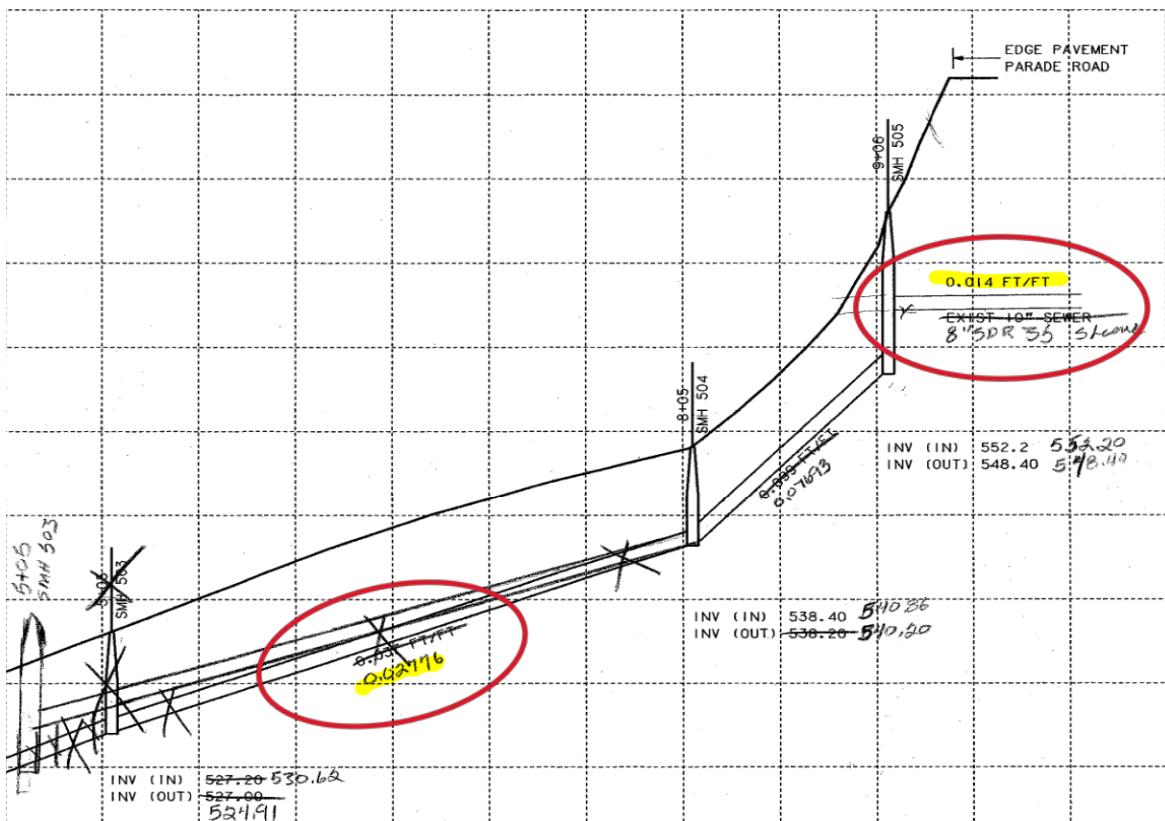

PROFILE

Source: "SEWER REPLACEMENT PLANS", Project: 97418, Lakes Region Development Center, NHDOC, Project 97418, dated 03-31-1995, marked "As-Built Plans" Sheets C1 and C2.

WATER DEMAND

Water demand for the proposed Laconia State School project are based on sewer demand calculations and are summarized below. Flow calculations are based on sewer flows per NHDES Table 1008-1 and are attached to this Memo.

Current Usage.

Dwinnell building (E-911 dispatch center):

50 employees daily X 15 GPD / Employee = 750 GPD.

This building will be vacated prior to Phase 1 construction and thus can be disregarded in full-build calculations.

Phase 1: Daily Usage:

48,300 GPD Average Usage x 1.1 = 53,300 GPD

Average x peaking factor (6) = 225 gpm peak flow

Full Build: Daily Flow:

627,000 GPD Average Usage x 1.1 = 690,000 GPD

Average x peaking factor (4.4) = 2,100 gpm

WATER SUPPLY

Existing Offsite Water Supply

Preliminary discussions with the Laconia Water Department provided the following information relative to existing water supply conditions at the site:

- The site is served by a single 6"-8" DI pipe that crosses Parade Road and connects to a 12" ductile iron pipe circa 1996 from downtown Laconia up Old N. Main Street to Parade Road.
- A 10" cast iron pipe circa 1957 runs north along Parade Road from Old North Main Street to Anthony Drive, where it joins another 12" cast iron pipe circa 1966. The 12" pipes are believed to be in acceptable condition, but the 10" cast iron pipe is approaching end of life.
- The 6"-8" pipe needs to be replaced across Parade Road with a 12" DI pipe to provide sufficient water to serve Phase 1 development.
- There is sufficient water capacity to service at least the Phase 1 portion of the site, although larger buildings in Phase 1 may require a fire pump. Pressure may be marginal for multi-story buildings and the higher-elevation phases of the project.
- The two existing water tanks on the site are not suitable for potable water, although one tank is in service for irrigation water to the Robbie Mills sports complex across Eastman Road.
- The Water Department recommends a new 1MG water tank with a small pump station to house booster pumps and controls be installed at or near the existing tank location (highest elevation on site).

SUMMARY:

Phase 1. The new 12" pipe across Parade Road will accommodate Phase 1 peak water demand. Hydrant flow tests have been performed, and initial results appear favorable. Once the final report is available, adequacy of flow for Phase 1 can be confirmed.

Full-Build 2. With new 1 MGD water tank in place, adequate water supply can be assured by selection of appropriate tank booster pump to accommodate peak flow rate of the development.