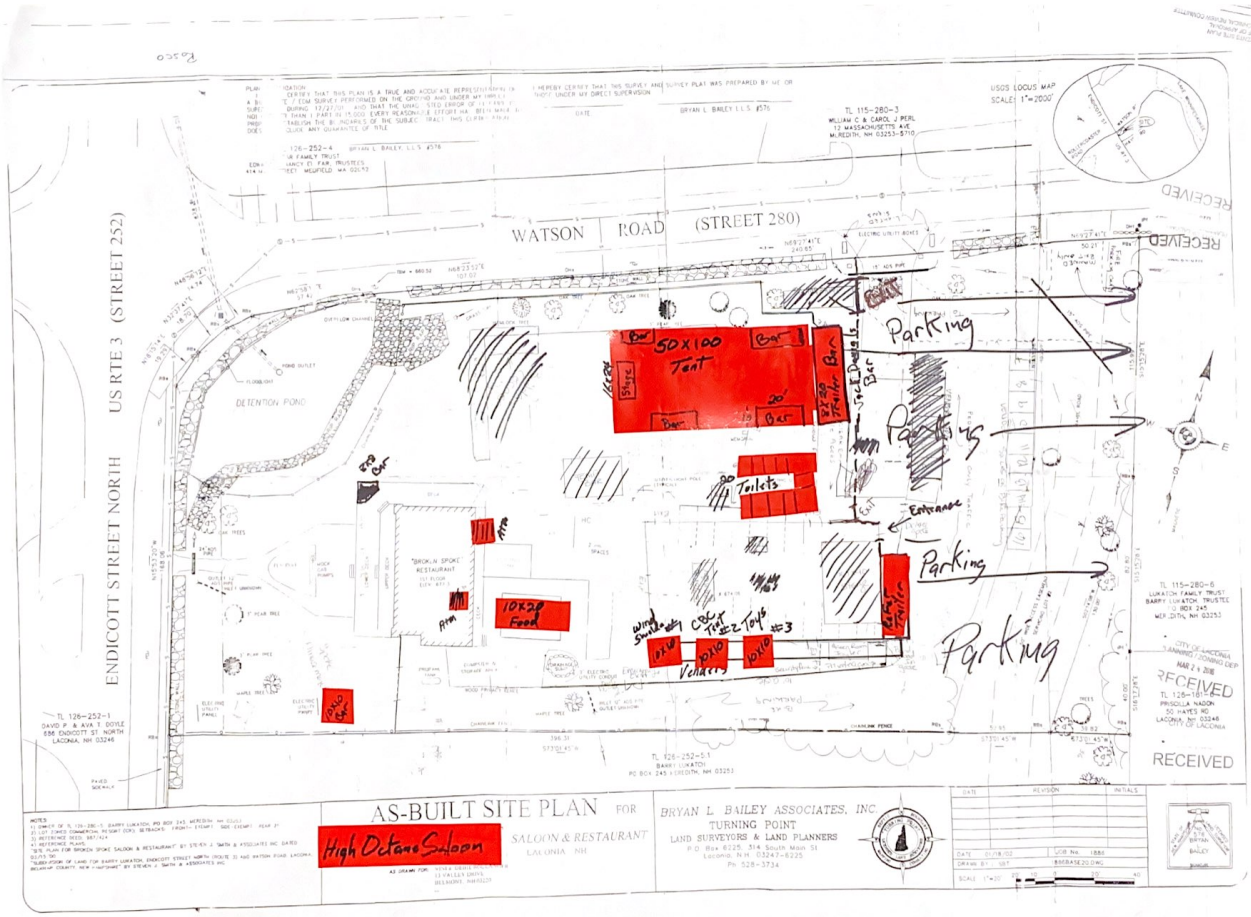

WATSON ROAD (STREET 280)
ENDICOTT STREET NORTH US RTE 3 (STREET 252)
DETENTION POND
50X100 Tent
Bar
Stage
8X20 Trailer Bar
Jack Daniels Bar
Parking
Toilets
Entrance
Parking
Parking
Parking
10X20 Food
Wind Shields #1
CBC Tent #2
Toys #3
10X10
10X10
10X10
Venders
Retail Trailer
RECEIVED
RECEIVED
RECEIVED
RECEIVED
USGS LOCUS MAP
SCALE: 1"=2000'
TL 115-280-3
WILLIAM C & CAROL J PERL
12 MASSACHUSETTS AVE
MEREDITH, NH 03253-5710
TL 126-252-1
DAVID P & AVA T. DOYLE
686 ENDICOTT ST NORTH
LACONIA, NH 03246
TL 126-252-5.1
BARRY LUKATCH
PO BOX 245 MEREDITH, NH 03253
TL 115-280-6
LUKATCH FAMILY TRUST
BARRY LUKATCH TRUSTEE
PO BOX 245
MEREDITH, NH 03253
TL 126-181-6
PRISCILLA NADON
50 HAYES RD
LACONIA, NH 03246
CITY OF LACONIA
PLANNING / ZONING DEP
MAR 2 4 2016
AS-BUILT SITE PLAN FOR
High Octane Saloon
SALOON & RESTAURANT
LACONIA NH
BRYAN L BAILEY ASSOCIATES, INC.
TURNING POINT
LAND SURVEYORS & LAND PLANNERS
P.O. Box 6225, 314 South Main St
Laconia, N.H. 03247-6225
Ph 528-3734